

STATE ENGINEER
Salem, Oregon

15438
M 471.....

Well Record

STATE WELL NO. 9/3W-34Q(1)
COUNTY Marion
APPLICATION NO. GR-404

OWNER: Dale L. Turnidge


MAILING ADDRESS: Rt. 1

LOCATION OF WELL: Owner's No. Mint still

CITY AND STATE: Jefferson, Oregon

SW 1/4 SE 1/4 Sec. 34 T. 9 S., R. 3 W., W.M.

Bearing and distance from section or subdivision corner 880' N. & 1540' W. of SE cor. of sec. 34

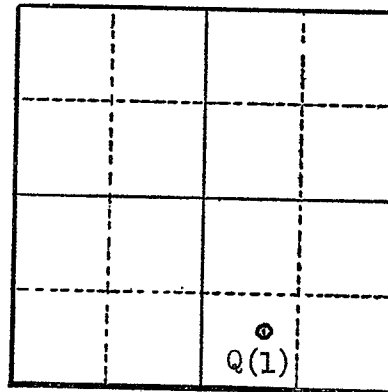

Section 34

Altitude at well 225'

TYPE OF WELL: Drilled Date Constructed 1945

Depth drilled 40' Depth cased 40'

CASING RECORD:

8 inch set from 0 to 40 feet

FINISH:

Torch cut slots (8"x1/2" - 4/ft.) from 32 to 40 feet

AQUIFERS:

WATER LEVEL:

16 feet below land surface

PUMPING EQUIPMENT: Type Berkeley, Centrifugal H.P. 3
Capacity 150 G.P.M.

WELL TESTS:

Drawdown ft. after hours G.P.M.

Drawdown ft. after hours G.P.M.

USE OF WATER Industrial Temp. °F., 19

SOURCE OF INFORMATION GR-387

DRILLER or DIGGER

ADDITIONAL DATA:

Log NA Water Level Measurements Chemical Analysis Aquifer Test

REMARKS: