

OWNER: Dale L. Turnidge


MAILING ADDRESS: Rt. 1

LOCATION OF WELL: Owner's No. 5

CITY AND STATE: Jefferson, Oregon

SW 1/4 SE 1/4 Sec. 34 T. 9 S., R. 3 W., W.M.

Bearing and distance from section or subdivision corner 950' N. & 1875' W. of SE cor. of sec. 34

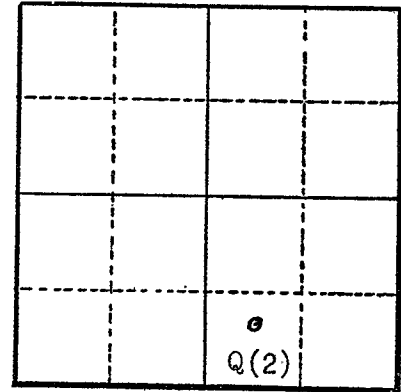

Altitude at well 225'

TYPE OF WELL: Drilled Date Constructed 1938

Depth drilled 40' Depth cased 40'

Section 34

CASING RECORD:

8 inch set from 0 to 40 feet

FINISH:

Torch cut slots (8"x1/2" - 4/ft.) from 30 to 40 feet

AQUIFERS:

Sand & gravel located at 6 to 40 feet

WATER LEVEL:

16 feet below land surface

PUMPING EQUIPMENT: Type F. M. Centrifugal

H.P. 5

Capacity G.P.M.

WELL TESTS:

Drawdown ft. after hours G.P.M.

Drawdown ft. after hours G.P.M.

USE OF WATER Irrigation (10 acres)

Temp. °F. 19

SOURCE OF INFORMATION GR- 387

DRILLER or DIGGER

ADDITIONAL DATA:

Log Water Level Measurements Chemical Analysis Aquifer Test

REMARKS:

Sandy loam 0 to 6
Sand & gravel 6 to 40