

STATE ENGINEER  
Salem, Oregon

15519  
MARI....

# Well Record

STATE WELL NO. 9/4W-13J  
COUNTY Marion  
APPLICATION NO. GR. 1302

GR. 1259

OWNER: Carl T. Morris


MAILING ADDRESS: Rt. 1, Box 96

LOCATION OF WELL: Owner's No. #1

CITY AND STATE: Jefferson, Oregon

NE 1/4 SE 1/4 Sec. 13 T. 9 S., R. 4 W., W.M.

Bearing and distance from section or subdivision corner 1200' W. & 2250' N. from SE cor. Sec. 13.

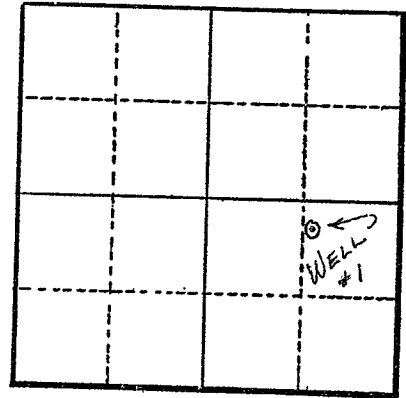

Section 13

Altitude at well

TYPE OF WELL: Drilled Date Constructed 1943

Depth drilled 33 ft. 10 in. Depth cased 33 ft. 10 in.

### CASING RECORD:

10 inch from 8 to 33 ft. 10 in.

### FINISH:

Perforations: 1 x 8 in. - 2 per ft. from 23 to 33 ft.

### AQUIFERS:

### WATER LEVEL:

12 ft.

PUMPING EQUIPMENT: Type Cornell Cent.

Capacity 575 G.P.M. H.P. 20

### WELL TESTS:

Drawdown 12 ft. after \_\_\_\_\_ hours 600 G.P.M.

Drawdown \_\_\_\_\_ ft. after \_\_\_\_\_ hours \_\_\_\_\_ G.P.M.

USE OF WATER Irrigation Temp. \_\_\_\_\_ °F. 19

SOURCE OF INFORMATION G. R. Record

DRILLER or DIGGER

### ADDITIONAL DATA:

Log N.A. Water Level Measurements \_\_\_\_\_ Chemical Analysis \_\_\_\_\_ Aquifer Test \_\_\_\_\_

### REMARKS:

Irrigation of 51.82 acres.