

STATE ENGINEER
Salem, Oregon

MARI 15585

Well Record

STATE WELL NO. 9/4W - 23Q
COUNTY MARION
APPLICATION NO. GR-2271

OWNER: H. F. Louie Willamette Hop Co.


MAILING ADDRESS: Route 1

LOCATION OF WELL: Owner's No.

CITY AND STATE: Jefferson, Oregon

SW 1/4 SE 1/4 Sec. 23 T. 9 N. S. R. 4 E. W., W.M.

Bearing and distance from section or subdivision corner 100' E. and 50' N.

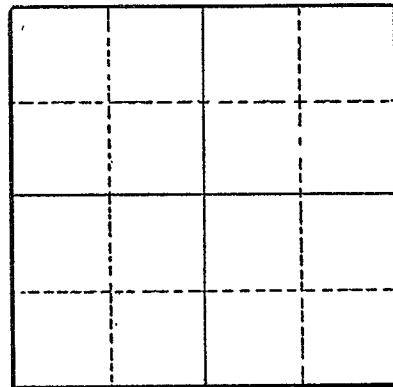

Section

Altitude at well

TYPE OF WELL: Drilled Date Constructed 1938

Depth drilled 42 Depth cased 42

CASING RECORD:

12-Inch

FINISH:

AQUIFERS:

Sand and gravel

WATER LEVEL:

15-Feet

PUMPING EQUIPMENT: Type Centrifugal H.P. 25
Capacity 500 G.P.M.

WELL TESTS:

Drawdown ft. after hours G.P.M.
Drawdown ft. after hours G.P.M.

USE OF WATER Irrigation Temp. °F. 19

SOURCE OF INFORMATION GR-2164

DRILLER or DIGGER Sloper

ADDITIONAL DATA:

Log Water Level Measurements Chemical Analysis Aquifer Test

REMARKS:

Sand and gravels