

STATE ENGINEER  
Salem, Oregon

MAR1...  
15524

# Well Record

STATE WELL NO. 9/LW-24C(1)  
COUNTY Marion  
APPLICATION NO. GR- 191

OWNER: William Wiederkehr


MAILING  
ADDRESS:

LOCATION OF WELL: Owner's No. 1

CITY AND  
STATE: Jefferson, Oregon

NE 1/4 NW 1/4 Sec. 24 T. 9 S., R. 4 W., W.M.

Bearing and distance from section or subdivision  
corner 35 ch. S. & 6 ch. W. from NE cor. of DLC #56

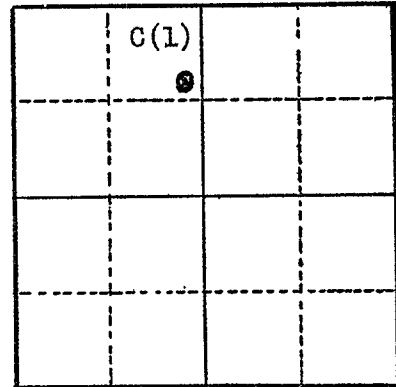

Altitude at well 172'

Section 24

TYPE OF WELL: Drilled Date Constructed

Depth drilled 24' Depth cased 24'

### CASING RECORD:

4x8 foot pit, 3 feet deep - 12 inch casing set from 3 to 24 feet

### FINISH:

### AQUIFERS:

### WATER LEVEL:

8 feet below land surface

PUMPING EQUIPMENT: Type F. M. H.P. 15  
Capacity 400 G.P.M.

### WELL TESTS:

Drawdown ft. after hours G.P.M.  
Drawdown ft. after hours G.P.M.

USE OF WATER Irrigation (35 acres) Temp. °F. 19

SOURCE OF INFORMATION GR- 177

DRILLER or DIGGER Fred Wymore

### ADDITIONAL DATA:

Log NA Water Level Measurements Chemical Analysis Aquifer Test

### REMARKS: