

STATE ENGINEER
Salem, Oregon

M 3
15530

Well Record

STATE WELL NO. 2/W-24L(1)
COUNTY Marion
APPLICATION NO. GR-494

OWNER: Jake W. Gilmore


MAILING
ADDRESS:

LOCATION OF WELL: Owner's No. 1

CITY AND STATE: Jefferson, Oregon

NE 1/4 SW 1/4 Sec. 24 T. 9 S., R. 4 W., W.M.

Bearing and distance from section or subdivision
corner S. 89°18' E. 9.22 ch. from SE cor. of the
Wm. Helm DLC #56

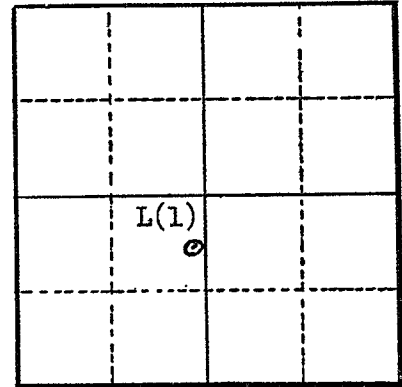

Altitude at well 170'

TYPE OF WELL: Drilled Date Constructed 1929

Depth drilled 35' Depth cased 35'

Section 24

CASING RECORD:

8 inch

FINISH:

AQUIFERS:

WATER LEVEL:
8 feet

PUMPING EQUIPMENT: Type F. M. Centrifugal H.P. 15
Capacity 350 G.P.M.

WELL TESTS:
Drawdown 8 ft. after hours 350 G.P.M.
Drawdown ft. after hours G.P.M.

USE OF WATER Irrigation (41 acres) Temp. °F. 19
SOURCE OF INFORMATION GR-474
DRILLER or DIGGER R. Q. West

ADDITIONAL DATA:

Log NA Water Level Measurements Chemical Analysis Aquifer Test

REMARKS: