

STATE ENGINEER  
Salem, Oregon

553  
MAR 1930

# Well Record

STATE WELL NO. 9/LW-24L(2)  
COUNTY Marion  
APPLICATION NO. GR- 494

OWNER: Jake W. Gilmore


MAILING ADDRESS:

LOCATION OF WELL: Owner's No. 2

CITY AND STATE: Jefferson, Oregon

NE 1/4 SW 1/4 Sec. 24 T. 9 S., R. 4 W., W.M.

Bearing and distance from section or subdivision corner N.73°25'W. 24.417 ch. from SE cor. of the Wm. Helm DLC #56

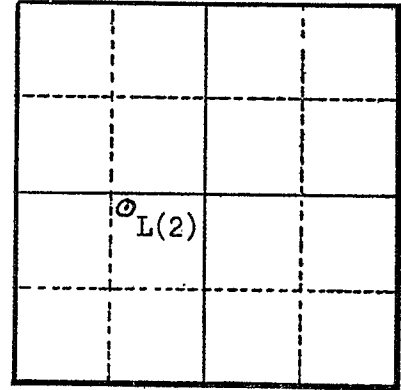

Section 24

Altitude at well 170'

TYPE OF WELL: Drilled Date Constructed 1930

Depth drilled 30' Depth cased 30'

CASING RECORD:  
8 Inch

FINISH:

AQUIFERS:

WATER LEVEL:  
8 feet

PUMPING EQUIPMENT: Type F. M. Centrifugal H.P. 10  
Capacity 240 G.P.M.

WELL TESTS:

Drawdown ..... ft. after ..... hours ..... G.P.M.  
Drawdown ..... ft. after ..... hours ..... G.P.M.

USE OF WATER Ind. & Irr. (23 acres) Temp. °F. , 19

SOURCE OF INFORMATION GR- 474

DRILLER or DIGGER West & Son

ADDITIONAL DATA:

Log  Water Level Measurements ..... Chemical Analysis ..... Aquifer Test .....

REMARKS:

Soil & clay 0 to 18  
Gravel 18 to 30