

STATE ENGINEER
Salem, Oregon

MARI...
15532

Well Record

STATE WELL NO. 9/LW-2LM(1)
COUNTY Marion
APPLICATION NO. GR-494

OWNER: Jake W. Gilmore


MAILING ADDRESS:

LOCATION OF WELL: Owner's No. 3

CITY AND STATE: Jefferson, Oregon

NW 1/4 SW 1/4 Sec. 24 T. 9 S, R. 4 W., W.M.

Bearing and distance from section or subdivision corner N.78°26'W. 29.175 ch. from SE cor. of the Wm. Helm DLC #56

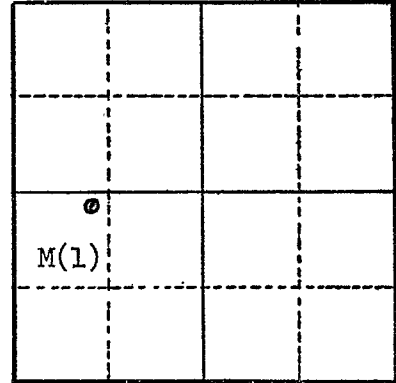

Altitude at well 170'

TYPE OF WELL: Drilled Date Constructed 1930

Depth drilled 33' Depth cased 33'

Section 24

CASING RECORD:

10 or 12 inch ???

FINISH:

AQUIFERS:

WATER LEVEL:

10 feet

PUMPING EQUIPMENT: Type F. M. Centrifugal H.P. 15
Capacity 350 G.P.M.

WELL TESTS:

Drawdown 7 ft. after 350 G.P.M.
Drawdown ft. after hours G.P.M.

USE OF WATER Irrigation (29 acres) Temp. °F. 19

SOURCE OF INFORMATION GR-474

DRILLER or DIGGER Fred Wymore

ADDITIONAL DATA:

Log NA Water Level Measurements Chemical Analysis Aquifer Test

REMARKS: