

STATE ENGINEER
Salem, Oregon

15532
MAR 21 1936

Well Record

STATE WELL NO. 9/LW-24M(2)
COUNTY Marion
APPLICATION NO. GR-485

OWNER: David & Wilma Turnidge


MAILING
ADDRESS: _____

LOCATION OF WELL: Owner's No. 2

CITY AND
STATE: Jefferson, Oregon

NW $\frac{1}{4}$ SW $\frac{1}{4}$ Sec. 24 T. 9 S., R. 4 W., W.M.

Bearing and distance from section or subdivision
corner 495' E. & 1320' N. from SW cor. of sec. 24

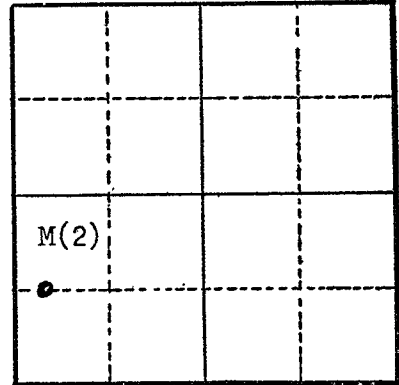

Altitude at well 170'

TYPE OF WELL: Drilled Date Constructed 1936

Depth drilled 26' Depth cased 26'

Section 24

CASING RECORD:

Pit - 4' x 6' x 10' deep
12 inch casing from 10 to 26 feet

FINISH:

AQUIFERS:

WATER LEVEL:
14 feet

PUMPING EQUIPMENT: Type F. M. H.P. 10
Capacity 300 G.P.M.

WELL TESTS:

Drawdown _____ ft. after _____ hours _____ G.P.M.
Drawdown _____ ft. after _____ hours _____ G.P.M.

USE OF WATER Irrigation (170 acres) Temp. _____ °F. _____, 19____

SOURCE OF INFORMATION GR-467

DRILLER or DIGGER ? dead

ADDITIONAL DATA:

Log Water Level Measurements _____ Chemical Analysis _____ Aquifer Test _____

REMARKS:

Sandy loam 0 to 14
Sand & gravel 14 to 26