

STATE ENGINEER
Salem, Oregon

MAR. 1954

Well Record

STATE WELL NO. 9/LW-24N(1)
COUNTY Marion
APPLICATION NO. GR-485

OWNER: David & Wilma Turnidge


MAILING ADDRESS:

LOCATION OF WELL: Owner's No. 2

CITY AND STATE: Jefferson, Oregon

SW 1/4 SW 1/4 Sec. 24 T. 9 S., R. 4 W., W.M.

Bearing and distance from section or subdivision
corner 495' E. & 370' N. of SE cor. of sec. 24

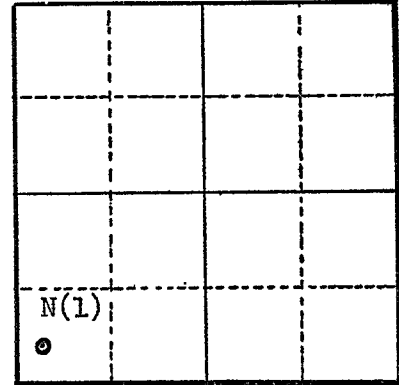

Altitude at well 180'

TYPE OF WELL: Drilled Date Constructed 1951

Depth drilled 35' Depth cased 25'

Section 24

CASING RECORD:

Pit - 4' x 8' x 10' deep
10 inch casing from 10 to 35 feet

FINISH:

AQUIFERS:

WATER LEVEL:

15 feet

PUMPING EQUIPMENT: Type F. M. H.P. 10

Capacity 300 G.P.M.

WELL TESTS:

Drawdown ft. after hours G.P.M.

Drawdown ft. after hours G.P.M.

USE OF WATER Irrigation (170 acres) Temp. °F., 19

SOURCE OF INFORMATION GR-467

DRILLER or DIGGER

ADDITIONAL DATA:

Log X Water Level Measurements Chemical Analysis Aquifer Test

REMARKS:

Sandy loam 0 to 14
Sand & gravel 14 to 35