

STATE ENGINEER
Salem, Oregon

Marion
15542

Well Record

STATE WELL NO. 9/LW-25E(1)
COUNTY Marion
APPLICATION NO. GR- 485

OWNER: David & Wilma Turnidge


MAILING ADDRESS: _____

LOCATION OF WELL: Owner's No. 5

CITY AND STATE: Jefferson, Oregon

SW 1/4 NW 1/4 Sec. 25 T. 9 S., R. 4 W., W.M.

Bearing and distance from section or subdivision corner 573' E. & 1630' S. of NW cor. of sec. 25

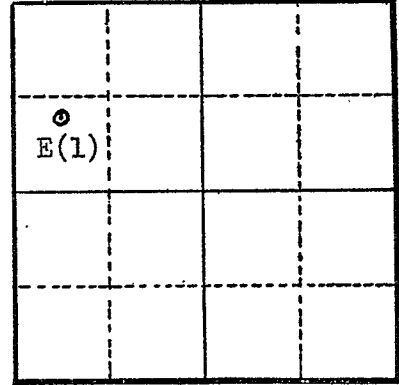

Altitude at well 182'

TYPE OF WELL: Drilled Date Constructed 1936

Depth drilled 27' Depth cased 17'

Section 25

CASING RECORD:

Pit - 2' x 6' x 10' deep

12 inch casing from 10 to 27 feet

FINISH:

AQUIFERS:

WATER LEVEL:

14 feet

PUMPING EQUIPMENT: Type F. M. H.P. 10

Capacity 300 G.P.M.

WELL TESTS:

Drawdown _____ ft. after _____ hours _____ G.P.M.

Drawdown _____ ft. after _____ hours _____ G.P.M.

USE OF WATER Irrigation (170 acres) Temp. _____ °F., 19

SOURCE OF INFORMATION GR- 467

DRILLER or DIGGER _____

ADDITIONAL DATA:

Log Water Level Measurements _____ Chemical Analysis _____ Aquifer Test _____

REMARKS:

Sandy loam 0 to 14
Sand & gravel 14 to 27