

STATE ENGINEER
Salem, Oregon

15543
MARION

Well Record

STATE WELL NO. 9/LW-25E(2)
COUNTY Marion
APPLICATION NO. GR-485

OWNER: David & Wilma Turnidge


MAILING ADDRESS:

LOCATION OF WELL: Owner's No. 4

CITY AND STATE: Jefferson, Oregon

SW 1/4 NW 1/4 Sec. 25 T. 9 S., R. 4 W., W.M.

Bearing and distance from section or subdivision corner 475' E. & 1605' S. of NW cor. of sec. 25

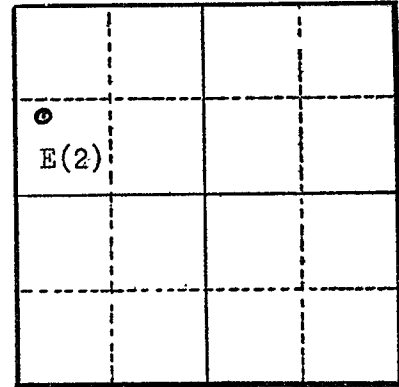

Altitude at well 182'

Section 25

TYPE OF WELL: Drilled Date Constructed 1936

Depth drilled 32' Depth cased 22'

CASING RECORD:

Pit - 2' x 6' x 10' deep

8 inch casing from 10 to 32 feet

FINISH:

AQUIFERS:

WATER LEVEL:
14 feet

PUMPING EQUIPMENT: Type F. M. H.P. 10
Capacity 300 G.P.M.

WELL TESTS:

Drawdown ft. after hours G.P.M.
Drawdown ft. after hours G.P.M.

USE OF WATER Irrigation (170 acres) Temp. °F. 19

SOURCE OF INFORMATION GR-467

DRILLER or DIGGER

ADDITIONAL DATA:

Log Water Level Measurements Chemical Analysis Aquifer Test

REMARKS:

Sandy loam 0 to 14
Sand & gravel 14 to 32