

STATE ENGINEER  
Salem, Oregon

MARION  
15545

# Well Record

STATE WELL NO. 9/LW-25F(1)  
COUNTY Marion  
APPLICATION NO. GR- 515

OWNER: Oscar Hoven


MAILING ADDRESS: 1165 Barnes Ave.

LOCATION OF WELL: Owner's No.

CITY AND STATE: Salem, Oregon

SE  $\frac{1}{4}$  NW  $\frac{1}{4}$  Sec. 25 T. 9 S., R. 4 W., W.M.

Bearing and distance from section or subdivision corner 395' N. & 1216' W. of center of sec. 25

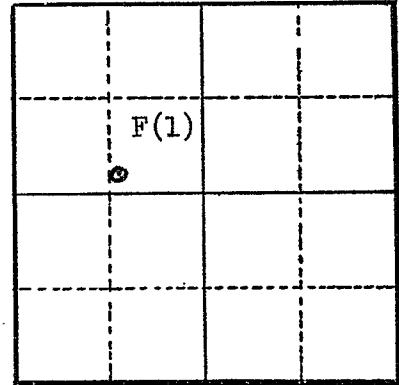

Altitude at well 200'

Section 25

TYPE OF WELL: Drilled Date Constructed May 1942

Depth drilled 40' Depth cased

### CASING RECORD:

10 inch

### FINISH:

### AQUIFERS:

### WATER LEVEL:

20 feet

PUMPING EQUIPMENT: Type F. M. Centrifugal H.P. 15

Capacity G.P.M.

### WELL TESTS:

Drawdown ft. after hours G.P.M.

Drawdown ft. after hours G.P.M.

USE OF WATER Irrigation (28 acres) Temp. °F., 19

SOURCE OF INFORMATION GR- 493

### DRILLER or DIGGER

### ADDITIONAL DATA:

Log NA Water Level Measurements Chemical Analysis Aquifer Test

### REMARKS: