

STATE ENGINEER
Salem, Oregon

MARION
15540

Well Record


STATE WELL NO. 9/4M-25G
COUNTY Marion
APPLICATION NO. GR-3074

OWNER: William and Walburga Krebs
MAILING ADDRESS: 2415 12th Street

LOCATION OF WELL: Owner's No. 3
CITY AND STATE: Salem, Oregon

SW 1/4 NE 1/4 Sec. 25 T. 9 S., R. 4 W., W.M.

Bearing and distance from section or subdivision
corner S. 71° 25' E., 315.0 ft. from the SE corner
of W. Wood DLG 55

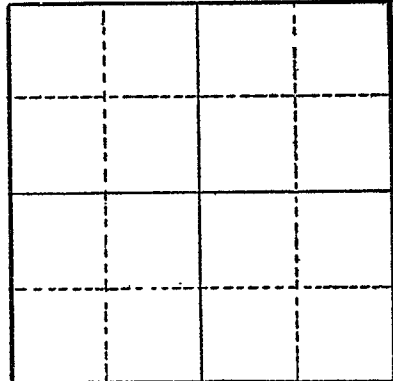

Section

Altitude at well

TYPE OF WELL: Drilled Date Constructed 1934

Depth drilled 30 feet Depth cased 30 feet

CASING RECORD:
12-inch

FINISH:

AQUIFERS:

WATER LEVEL:
13 feet

PUMPING EQUIPMENT: Type Cent. Dir. Dr. 4" x 3" H.P. 85
Capacity G.P.M.

WELL TESTS:
Drawdown 0 ft. after hours Pumping 550 G.P.M.
Drawdown ft. after hours G.P.M.

USE OF WATER Irrigation Temp. °F., 19

SOURCE OF INFORMATION GR-2877
DRILLER or DIGGER Sloper Plow Company

ADDITIONAL DATA:
Log Water Level Measurements Chemical Analysis Aquifer Test

REMARKS: