

STATE ENGINEER
Salem, Oregon

MAR. 1932
15547

Well Record

STATE WELL NO. 9/LW-25G(1)
COUNTY Marion
APPLICATION NO. GR- 543

OWNER: Clarence S. Starr


MAILING ADDRESS: 1225 W. 8th Ave.

LOCATION OF WELL: Owner's No.

CITY AND STATE: Albany, Oregon

SW 1/4 NE 1/4 Sec. 25 T. 9 S., R. 4 W., W.M.

Bearing and distance from section or subdivision corner 339' W. & 550' N. from SE cor. Wm. Wood DLC.

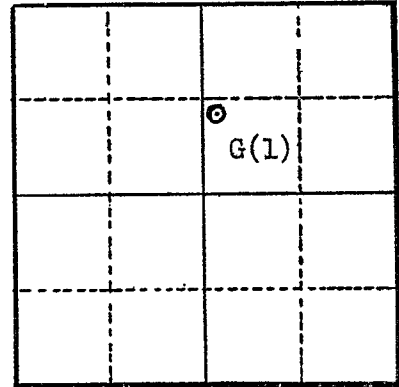

Section 25

Altitude at well 170'

TYPE OF WELL: Drilled Date Constructed 1932 (est.)

Depth drilled 32' Depth cased 32'

CASING RECORD:
12 inch

FINISH:

AQUIFERS:

WATER LEVEL:
16 feet

PUMPING EQUIPMENT: Type Centrifugal H.P. 10
Capacity 250 G.P.M.

WELL TESTS:
Drawdown ft. after hours G.P.M.
Drawdown ft. after hours G.P.M.

USE OF WATER Irrigation (18.3 acres) Temp. °F. 19

SOURCE OF INFORMATION GR- 518

DRILLER or DIGGER

ADDITIONAL DATA:
Log NA Water Level Measurements Chemical Analysis Aquifer Test

REMARKS: