

STATE ENGINEER
Salem, Oregon

MAR. 1934
15548

Well Record


STATE WELL NO. 9/4W-25H
COUNTY Marion
APPLICATION NO. GR-3075

OWNER: William and Walburga Krebs
MAILING ADDRESS: 2415 12th Street

LOCATION OF WELL: Owner's No. 4
CITY AND STATE: Salem, Oregon

SE 1/4 NE 1/4 Sec. 25 T. 9 N. S., R. 4 W., W.M.

Bearing and distance from section or subdivision
corner S. 87° 10' E., 1425 ft., from the SE corner of
W. Wood DLC 55

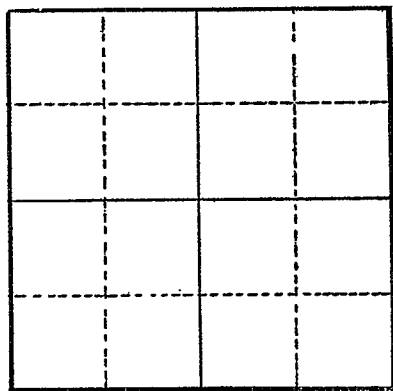

Section

Altitude at well

TYPE OF WELL: Drilled... Date Constructed 1934

Depth drilled 30 feet... Depth cased 30 feet

CASING RECORD:
12-inch

FINISH:

AQUIFERS:

WATER LEVEL:
13 feet

PUMPING EQUIPMENT: Type Cent. Dir. Dr. 4" x 3" H.P. 25
Capacity 550 G.P.M.

WELL TESTS:
Drawdown 0 ft. after ... hours Pumping 550 G.P.M.
Drawdown ... ft. after ... hours ... G.P.M.

USE OF WATER Irrigation Temp. ... °F. ... 19

SOURCE OF INFORMATION GR-2878
DRILLER or DIGGER Sloper Flow Company

ADDITIONAL DATA:
Log ... Water Level Measurements ... Chemical Analysis ... Aquifer Test

REMARKS: