

STATE ENGINEER  
Salem, Oregon

MAR. 1935  
15549


# Well Record

STATE WELL NO. 9/LW-25M(1)  
COUNTY Marion  
APPLICATION NO. GR-485

OWNER: David & Wilma Turnidge  
MAILING ADDRESS: \_\_\_\_\_

LOCATION OF WELL: Owner's No. 6  
CITY AND STATE: Jefferson, Oregon

NW 1/4 SW 1/4 Sec. 25 T. 9 S., R. 4 W., W.M.  
Bearing and distance from section or subdivision  
corner 1902' N. & 440' E. of SW cor. of sec. 25

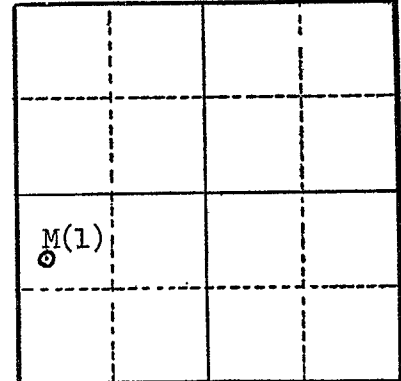

Altitude at well 175'

TYPE OF WELL: Drilled Date Constructed 1935  
Depth drilled 27' Depth cased 27'

Section 25

CASING RECORD:  
Pit - 3' x 6' x 8' deep  
12 inch casing from 8 to 27 feet

FINISH:

AQUIFERS:

WATER LEVEL:  
10 feet

PUMPING EQUIPMENT: Type F. M. H.P. 15  
Capacity 350 G.P.M.

WELL TESTS:  
Drawdown \_\_\_\_\_ ft. after \_\_\_\_\_ hours \_\_\_\_\_ G.P.M.  
Drawdown \_\_\_\_\_ ft. after \_\_\_\_\_ hours \_\_\_\_\_ G.P.M.

USE OF WATER Irrigation (170 acres) Temp. \_\_\_\_\_ °F., 19  
SOURCE OF INFORMATION GR-467

DRILLER or DIGGER \_\_\_\_\_  
ADDITIONAL DATA:  
Log  Water Level Measurements \_\_\_\_\_ Chemical Analysis \_\_\_\_\_ Aquifer Test \_\_\_\_\_

REMARKS:  
Sandy loam 0 to 14  
Sand & gravel 14 to 27