

STATE ENGINEER
Salem, Oregon

MAR. 15 1950

Well Record

STATE WELL NO. 9/4W-25M(3)
COUNTY Marion
APPLICATION NO. GR-1017

GR- 982

OWNER: Gordon E. Turnidge


MAILING ADDRESS: Rt. 1

LOCATION OF WELL: Owner's No. #1

CITY AND STATE: Jefferson, Oregon

NW ¼ SW ¼ Sec. 25 T. 9 S. R. 4 W., W.M.

Bearing and distance from section or subdivision corner 1170' E. & 540' S. from NW cor. Sec. 25.

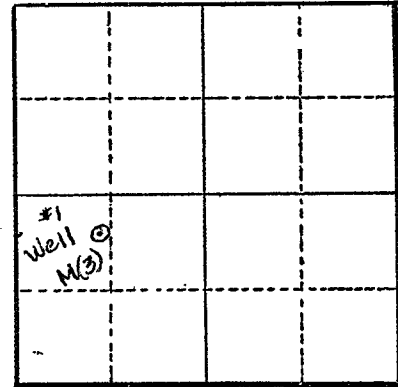

Section 25

Altitude at well 175 ft.

TYPE OF WELL: Drilled Date Constructed 1938

Depth drilled 24 ft. Depth cased 24 ft.

CASING RECORD:

10 inch

FINISH:

Torch slot perforations from 24 to 12 ft.

AQUIFERS:

WATER LEVEL:

10 ft.

PUMPING EQUIPMENT: Type F.M. 3" x 4" Cent. H.P. 15

Capacity 600 G.P.M.

WELL TESTS:

Drawdown 2 ft. after 1000 hours G.P.M.

Drawdown ft. after hours G.P.M.

USE OF WATER Irrigation Temp. °F. 19

SOURCE OF INFORMATION G.R. Record

DRILLER or DIGGER Wymore

ADDITIONAL DATA:

Log Water Level Measurements Chemical Analysis Aquifer Test

REMARKS:

Log: Top soil 0 to 10 ft.
Sand & gravel 10 to 24 ft.

Irrigation of 33 acres.