

STATE ENGINEER
Salem, Oregon

MAILED
15552

Well Record

STATE WELL NO. 9/4W-25Q(1)
COUNTY Marion
APPLICATION NO. GR-1018

GR- 983

OWNER: Gordon E. Turnidge

MAILING ADDRESS: Rt. 1


LOCATION OF WELL: Owner's No. #2

CITY AND STATE: Jefferson, Oregon

SW 1/4 SE 1/4 Sec. 25 T. 9 S. R. 4 W., W.M.

Bearing and distance from section or subdivision

corner 700' N. & 30' E. from S 1/4 cor. Sec. 25.

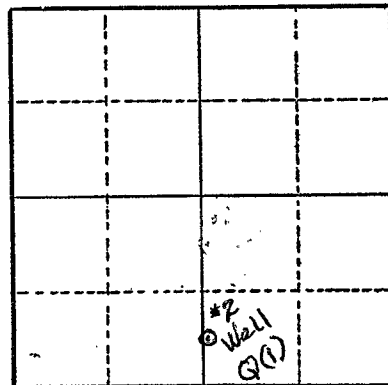

Section 25

Altitude at well

TYPE OF WELL: Drilled Date Constructed 1940

Depth drilled 26 ft. Depth cased 26 ft.

CASING RECORD:

12 inch

FINISH:

Torch slot perforations from 14 to 26 ft.

AQUIFERS:

WATER LEVEL:

14 ft.

PUMPING EQUIPMENT: Type Pacific H.P. 15

Capacity 600 G.P.M.

WELL TESTS:

Drawdown ft. after hours G.P.M.

Drawdown ft. after hours G.P.M.

USE OF WATER Irrigation Temp. °F., 19

SOURCE OF INFORMATION G.R. Record

DRILLER or DIGGER

ADDITIONAL DATA:

Log Water Level Measurements Chemical Analysis Aquifer Test

REMARKS:

Log: Top soil 0 to 12 ft.
Sand & gravel 12 to 26 ft.

Irrigation of 48 acres.