

STATE ENGINEER
Salem, Oregon

M.A.#.....
155516

Well Record

G5666

STATE WELL NO. 9/LW-26G(1)
COUNTY Marion
APPLICATION NO. GR-498

OWNER: J. Eldon & Mary Turnidge

MAILING ADDRESS:


LOCATION OF WELL: Owner's No. 3

CITY AND STATE:

Jefferson, Oregon

SW 1/4 NE 1/4 Sec. 26 T. 9 S., R. 4 W., W.M.

Bearing and distance from section or subdivision corner 990' E. & 575' N. of center of sec. 26

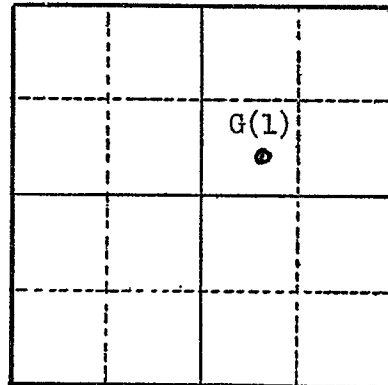

Section 26

Altitude at well 172'

TYPE OF WELL: Drilled Date Constructed 1944

Depth drilled 30' Depth cased 19'

CASING RECORD:

Pit - 5' x 7' x 11' deep

12 inch casing from 11 to 30 feet

FINISH:

AQUIFERS:

WATER LEVEL:

19 feet

PUMPING EQUIPMENT: Type F. M. Centrifugal H.P. 15
Capacity 350 G.P.M.

WELL TESTS:

Drawdown ft. after hours G.P.M.

Drawdown ft. after hours G.P.M.

USE OF WATER Irrigation (55 acres) Temp. °F. 19

SOURCE OF INFORMATION GR-477

DRILLER or DIGGER

ADDITIONAL DATA:

Log NA Water Level Measurements Chemical Analysis Aquifer Test

REMARKS: