

STATE ENGINEER  
Salem, Oregon

MAR. ....  
15559

# Well Record

STATE WELL NO. 9/LW-26H(3)  
COUNTY Marion  
APPLICATION NO. GR-485

OWNER: David & Wilma Turnidge

MAILING ADDRESS:

LOCATION OF WELL: Owner's No. 9


CITY AND STATE:

Jefferson, Oregon

SE 1/4 NE 1/4 Sec. 26 T. 9 S., R. 4 W., W.M.

Bearing and distance from section or subdivision

corner 2540' S. & 1300' W. of NE cor. of sec. 26

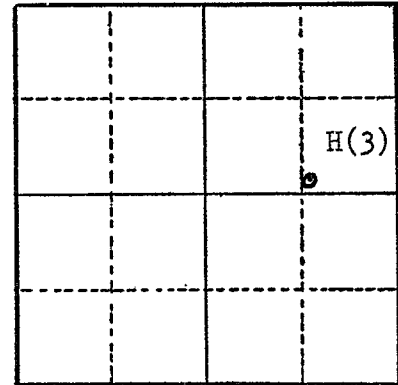

Section 26

Altitude at well 176'

TYPE OF WELL: Drilled Date Constructed 1930

Depth drilled 27' Depth cased 17'

### CASING RECORD:

Dug pit - 5' x 5' x 10' deep

12' inch casing from 10 to 27 feet

### FINISH:

### AQUIFERS:

### WATER LEVEL:

8 feet

PUMPING EQUIPMENT: Type F. M. H.P. 10

Capacity 350 G.P.M.

### WELL TESTS:

Drawdown ..... ft. after ..... hours ..... G.P.M.

Drawdown ..... ft. after ..... hours ..... G.P.M.

USE OF WATER Irrigation ( 52 acres ) Temp. ..... °F. ...., 19

SOURCE OF INFORMATION GR-467

DRILLER or DIGGER

### ADDITIONAL DATA:

Log NA Water Level Measurements ..... Chemical Analysis ..... Aquifer Test .....

### REMARKS: