NOTICE TO WATER WELL CONTRACTOR

The original and first copy of this report are to be filed with the


of well completion.

STATE ENGINEER, SALEM, OREG

WATER WELL REPORT

DOF CEIVE TATE OF OREGON ENGINEER, SALEM, OREGOES 9 within 30 days from the date.

JUL 20 1970(Deadt write above this line)

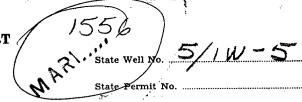

STATE ENGINEER SALEM, ORLLON (11) LOCATION OF WELL: (1) OWNER: Driller's well number 1498 County Marion Name Gary Simmins W.M. 5 T. 5S 14 Section Address Rt. 1 Box 33 A Woodburn, Oregon 97071 Bearing and distance from section or subdivision corner (2) TYPE OF WORK (check): Reconditioning [New Well Deepening [If abandonment, describe material and procedure in Item 12. (3) TYPE OF WELL: (4) PROPOSED USE (check): (12) WELL LOG: Diameter of well below casing Rotary Driven □ Domestic 🛣 Industrial 🗌 Municipal 🗍 Depth drilled ft. Depth of completed well Bored [Irrigation [Test Well [Other Dug Formation: Describe color, texture, grain size and structure of materials; and show thickness and nature of each stratum and aquifer penetrated, CASING INSTALLED: Threaded | Welded T with at least one entry for each change of formation. Report each change 6 "Diam. from top ft. to 128 ft. Gage 250 in position of Static Water Level as drilling proceeds. Note drilling rates." Diam. from ft. to ft. Gage MATERIAL Top Soil n 2 Yellow Clay 2 28 PERFORATIONS: Perforated? 🗌 Yes 🛣 No. Gray Clay 28 Type of perforator used Krancexxiik Blue Clay 56 91 Size of perforations in. by Brown silt 91 94 perforations from ft. to ft. Blue Clay 94 107 perforations from ______ ft. to _____ ft. Black sand 107 118 perforations from ft. to ft. Black sand and gravel Water 118 perforations from ft. to ft. perforations from ______ ft. to _____ ft. (7) SCREENS: Well screen installed? 🗌 Yes 🛣 No Manufacturer's Name Model No. Diam. Slot size Set from ft. to ft. Diam. Slot size Set from ft. to ft. (8) WATER LEVEL: Completed well. ft. below land surface Date 7-15-70 Static level an pressure lbs. per square inch Date Drawdown is amount water level is lowered below static level (9) WELL TESTS: Was a pump test made? [Yes Y No If yes, by whom? Work started 7-13-70 Completed 7-15-70 19 gal./min. with ft. drawdown after Date well drilling machine moved off of well 7-16-70 ,, Drilling Machine Operator's Certification: This well was constructed under my direct supervision. Mate-Bailer test gal./min. with 15 ft. drawdown after 2 hrs. rials used and information reported above are true to my best knowledge and belief. g.p.m. Date Artesian flow Date 7-16-70, 19..... Was a chemical analysis made?

Yes

No Temperature of water (10) CONSTRUCTION: Drilling Machine Operator's License No. 141 Well seal-Material used Cement and Puddle Clay Water Well Contractor's Certification: This well was drilled under my jurisdiction and this report is8 in. Diameter of well bore to bottom of seal true to the best of my knowledge and belief. Were any loose strata cemented off? Tes 🍱 No Depth NAME WILLAMETTE DRILLING COMPANY
(Person, firm or corporation) (Type or print) Was a drive shoe used? W Yes 🔲 No Did any strata contain unusable water? Yes No Address 7641...35th Ave. NE Salem, Oregon 97303... depth of strata Type of water? Method of sealing strata off Was well gravel packed?

Yes No Size of gravel: Gravel placed from _____ft. to _____ft.