

STATE ENGINEER
Salem, Oregon

MARI.....
1 5560

Well Record

STATE WELL NO. 9/4W-26J(1)
COUNTY Marion
APPLICATION NO. GR-485

OWNER: David & Wilma Turnidge

MAILING ADDRESS:

LOCATION OF WELL: Owner's No. 10


CITY AND STATE:

Jefferson, Oregon

NE 1/4 SE 1/4 Sec. 26 T. 9 S., R. 4 W., W.M.

Bearing and distance from section or subdivision

corner 1145' N. & 660' W. of SE cor. of sec. 26

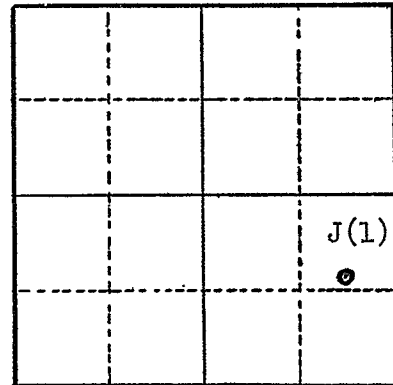

Section 26

Altitude at well 174'

TYPE OF WELL: Drilled Date Constructed 1932

Depth drilled 25' Depth cased 15'

CASING RECORD:

Dug pit - 5' x 5' x 10' deep

10 inch casing from 10 to 25 feet

FINISH:

AQUIFERS:

WATER LEVEL:

6 feet

PUMPING EQUIPMENT: Type F. M. H.P. 15
Capacity 350 G.P.M.

WELL TESTS:

Drawdown ft. after hours G.P.M.
Drawdown ft. after hours G.P.M.

USE OF WATER Irrigation (60 acres) Temp. °F., 19

SOURCE OF INFORMATION GR-467

DRILLER or DIGGER

ADDITIONAL DATA:

Log NA Water Level Measurements Chemical Analysis Aquifer Test

REMARKS: