

STATE ENGINEER
Salem, Oregon

MARI.....
15566

Well Record

STATE WELL NO. 9/4W-36R
COUNTY ~~Wasco~~ Marion
APPLICATION NO. GR-1504

GR- 1525

OWNER: N. L. Grate


MAILING ADDRESS: Rt. 2, Box 356

LOCATION OF WELL: Owner's No. #1

CITY AND STATE: Albany, Oregon

SE 1/4 SE 1/4 Sec. 36 T. 9 S., R. 4 W., W.M.

Bearing and distance from section or subdivision corner N. 52° 30' W. 13.75 ch. from SE cor. Sec. 36

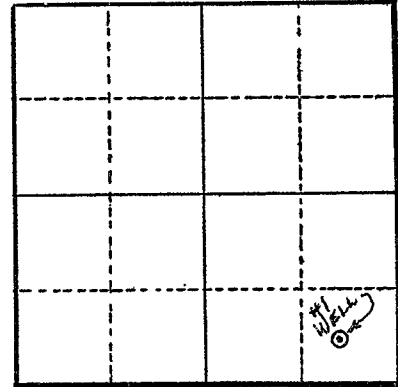

Section 36

Altitude at well 180'

TYPE OF WELL: Drilled Date Constructed 1944

Depth drilled 28' Depth cased 28'

CASING RECORD:

10"

FINISH:

Slot perforations from 25 to 28 ft.

AQUIFERS:

WATER LEVEL:

13'

PUMPING EQUIPMENT: Type 3" Cent. H.P. 20
Capacity 400 G.P.M.

WELL TESTS:

Drawdown ft. after hours G.P.M.
Drawdown ft. after hours G.P.M.

USE OF WATER Irrigation Temp. °F. 19

SOURCE OF INFORMATION GR Record

DRILLER or DIGGER Bill Hamilton

ADDITIONAL DATA:

Log N.A. Water Level Measurements Chemical Analysis Aquifer Test

REMARKS:

Irrigation of 46.5 acres.