

STATE ENGINEER
Salem, Oregon

MARION
15614

Well Record

STATE WELL NO. 9/1-7F(1)
COUNTY Marion
APPLICATION NO. G-153

OWNER: Angus & Marcille D. Wape


MAILING ADDRESS: 107 E. Burnett St.

LOCATION OF WELL: Owner's No.

CITY AND STATE: Stayton, Oregon

SE 1/4 NW 1/4 Sec. 7 T. 9 S., R. 1 W.M.

Bearing and distance from section or subdivision corner 1630' E. & 376' N. of W 1/4 cor. of sec. 7

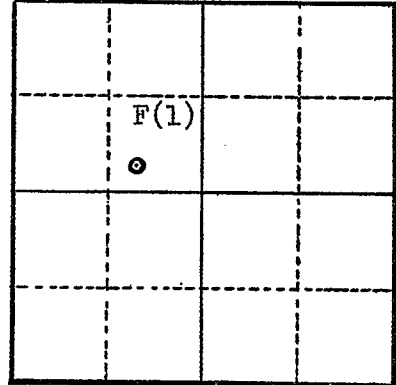

Section 7

Altitude at well

TYPE OF WELL: Drilled Date Constructed Oct. 1955

Depth drilled 50' Depth cased 47'

CASING RECORD:

8 inch set from 0 to 47 feet

FINISH:

Perforations set from 3 to 45 feet

AQUIFERS:

Sand & gravel

WATER LEVEL:

2 feet below land surface (Oct. 1955)

PUMPING EQUIPMENT: Type

H.P.

Capacity G.P.M.

WELL TESTS:

Drawdown 20 ft. after hours Bailing 30 G.P.M.

Drawdown ft. after hours G.P.M.

USE OF WATER Irrigation Temp. 48 °F. October 19 55

SOURCE OF INFORMATION Well drillers report

DRILLER or DIGGER ~~XXXXXXXXXXXXXXXXXXXXXXXXXXXXXXXXXXXX~~ Jack L. Klundt

ADDITIONAL DATA:

Log X Water Level Measurements Chemical Analysis Aquifer Test

REMARKS:

- Boulder & clay 0 to 5
- Sand, gravel & boulders 5 to 30
- Gravel & boulder 30 to 40
- Sand & gravel, cemented 40 to 45
- Clay, blue 45 to 50