

STATE ENGINEER
Salem, Oregon

MAR 1563

Well Record

GR-935

STATE WELL NO. 5/1W-5E
COUNTY Marion
APPLICATION NO. GR-964

OWNER: Albert Hubert Johnson


MAILING ADDRESS: Rt. 1, Box 237

LOCATION OF WELL: Owner's No. _____

CITY AND STATE: Woodburn, Oregon

SW $\frac{1}{4}$ NW $\frac{1}{4}$ Sec. 5 T. 5 S., R. 1 W., W.M.

Bearing and distance from section or subdivision
corner 500' E. & 1400' S. of NW cor. Sec. 5.

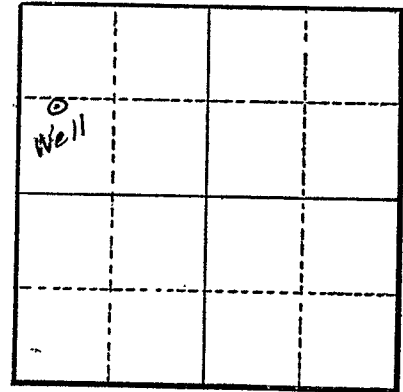

Section 5

Altitude at well 176 ft.

TYPE OF WELL: Drilled Date Constructed 1955

Depth drilled 113 ft. Depth cased 113 ft.

CASING RECORD:

6 inch

FINISH:

AQUIFERS:

WATER LEVEL:

25 ft.

PUMPING EQUIPMENT: Type Universal Jet H.P. 2
Capacity 25 G.P.M.

WELL TESTS:

Drawdown 20 ft. after _____ hours 50 G.P.M.

Drawdown _____ ft. after _____ hours _____ G.P.M.

USE OF WATER Irrigation Temp. _____ °F. _____, 19____

SOURCE OF INFORMATION G.R. Record

DRILLER or DIGGER Willamette Drilling Co.

ADDITIONAL DATA:

Log _____ Water Level Measurements _____ Chemical Analysis _____ Aquifer Test _____

REMARKS:

Irrigation of 8 acres.