

STATE ENGINEER  
Salem, Oregon

1564  
MARION

# Well Record

STATE WELL NO. 5/1W-5E(2)  
COUNTY Marion  
APPLICATION NO. CR-418

OWNER: Robert Dixon


MAILING ADDRESS: Route 1, Box 236

LOCATION OF WELL: Owner's No. 1

CITY AND STATE: Woodburn, Oregon

SW 1/4 NW 1/4 Sec. 5 T. 5 S., R. 1 W., W.M.

Bearing and distance from section or subdivision corner 9 chains E. & 18 chains S. from NE cor. Witney DLC 55

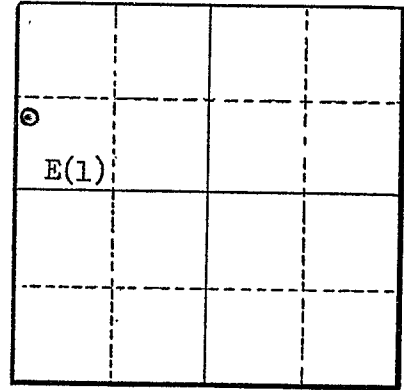

Section 5

Altitude at well 175

TYPE OF WELL: Drilled Date Constructed 1942

Depth drilled 118 Depth cased 18

### CASING RECORD:

6 inch

### FINISH:

### AQUIFERS:

### WATER LEVEL:

25

PUMPING EQUIPMENT: Type Jacuzzi Turbine H.P. 3  
Capacity 60 G.P.M.

### WELL TESTS:

Drawdown ft. after hours G.P.M.  
Drawdown ft. after hours G.P.M.

USE OF WATER Irrigation 12 acres Temp. °F. 19

SOURCE OF INFORMATION CR-418

DRILLER or DIGGER Pete Harrake, Canby, Oregon

### ADDITIONAL DATA:

Log No Water Level Measurements Chemical Analysis Aquifer Test

### REMARKS: