

STATE ENGINEER
Salem, Oregon

1569
MARION

Well Record


STATE WELL NO. 5/1W-5L(1)
COUNTY Marion
APPLICATION NO. GR-867

OWNER: Lynn Simon MAILING ADDRESS: _____

LOCATION OF WELL: Owner's No. _____ CITY AND STATE: _____

NE 1/4 SW 1/4 Sec. 5 T. 5 N. R. 1 E. W., W.M.

Bearing and distance from section or subdivision corner 2500' N. & 1700' E. from SW cor. Sec. 5

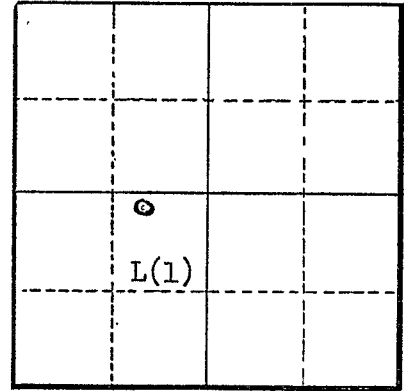

Altitude at well _____

TYPE OF WELL: Drilled Date Constructed Nov. '50

Depth drilled 120 Depth cased 120

Section _____

CASING RECORD:

10" steel casing 0 to 120'

FINISH:

Mills knife persorations 100 to 128'

AQUIFERS:

Black sand 100-116'
Sand and gravel 116- 120'

WATER LEVEL:

20'

PUMPING EQUIPMENT: Type Peerless turbine H.P. 25 Elec.
Capacity 300 G.P.M. U.S. Motor

WELL TESTS:

Drawdown 60 ft. after _____ hours 300 G.P.M.
Drawdown _____ ft. after _____ hours _____ G.P.M.

USE OF WATER Irrigation Temp. _____ °F. _____, 19.

SOURCE OF INFORMATION Owner

DRILLER or DIGGER Roy Perkins

ADDITIONAL DATA:

Log Water Level Measurements _____ Chemical Analysis _____ Aquifer Test _____

REMARKS:

