

STATE ENGINEER
Salem, Oregon

1572
MARI.....2

Well Record

GR- 1083

STATE WELL NO. 5/1W-5011
COUNTY Marion
APPLICATION NO. GR- 1123

OWNER: A. D. or Naomi Alleman

MAILING ADDRESS: Rt. 1, Box 18

LOCATION OF WELL: Owner's No.


CITY AND STATE: Woodburn, Oregon

SW 1/4 SE 1/4 Sec. 5 T. 5 S., R. 1 W., W.M.

Bearing and distance from section or subdivision

corner N89°32'W. 551.958' & S41°15'W. 1197.502' &

East 123' from the SE cor. of the P.M. Gleason DIC.

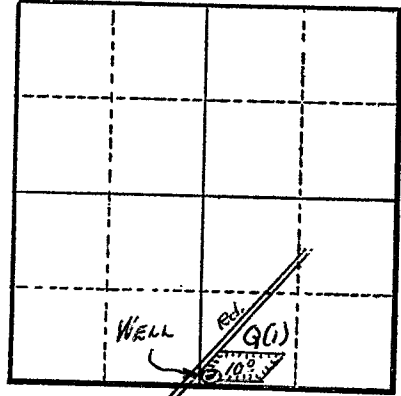

Altitude at well 178 ft.

TYPE OF WELL: Drilled Date Constructed 1932

Depth drilled 120 ft. Depth cased 120 ft.

CASING RECORD:

4 inch

FINISH:

AQUIFERS:

WATER LEVEL:

26 ft.

PUMPING EQUIPMENT: Type Jacuzzi Jet

Capacity 50 G.P.M. H.P. 1

WELL TESTS:

Drawdown 25 ft. after 250 hours G.P.M.

Drawdown ft. after hours G.P.M.

USE OF WATER Dom. & irrigation

Temp. °F. 19

SOURCE OF INFORMATION G. R. Record

DRILLER or DIGGER Myron Ballweber

ADDITIONAL DATA:

Log N.A. Water Level Measurements Chemical Analysis Aquifer Test

REMARKS:

Irrigation of 10.284 acres.