

STATE ENGINEER
Salem, Oregon

1523
MARI.....

Well Record

STATE WELL NO. 5/1W-5R(1)
COUNTY Marion
APPLICATION NO. GR-259

OWNER: Roy E. & Lydia Love


MAILING ADDRESS: 1 3/4 mi. north of Woodburn on 99E

LOCATION OF WELL: Owner's No.

CITY AND STATE: Woodburn, oregon

SE 1/4 SE 1/4 Sec. 5 T. 5 N. S. R. 1 W., W.M.

Bearing and distance from section or subdivision corner 400' North and 225' West from SE cor. of Sec. 5

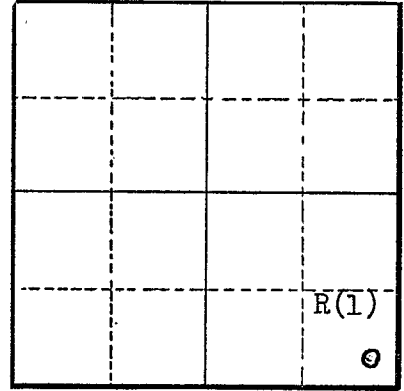

Section 5

Altitude at well 175' Interpolated

TYPE OF WELL: Drilled Date Constructed 4-5-48

Depth drilled 125 Depth cased 125

CASING RECORD:

8 inch casing set from 0 to 125 feet

FINISH:

none

AQUIFERS:

Sand and gravel from 70 to 125 feet

WATER LEVEL:

18 feet

PUMPING EQUIPMENT: Type Cook turbine 4" H.P. 5
Capacity 125 G.P.M. on 5 hour test

WELL TESTS:

Drawdown 85 ft. after hours pumping 100 G.P.M.
Drawdown 60 ft. after hours pumping 79 G.P.M.

USE OF WATER Irrigation 35 acres Temp. °F. 19

SOURCE OF INFORMATION Registration Statement GR-259

DRILLER or DIGGER

ADDITIONAL DATA:

Log yes Water Level Measurements Chemical Analysis Aquifer Test

REMARKS:

