

STATE ENGINEER
Salem, Oregon

OBSERVATION WELL
Well Record

STATE WELL NO. 3/1W-33H1
COUNTY Marion
APPLICATION NO. G 3340


MARI. 158
KLUPENGLER NURSERY

OWNER: L. H. Sammons MAILING ADDRESS: _____

LOCATION OF WELL: Owner's No. _____ CITY AND STATE: _____

_____ 1/4 _____ 1/4 Sec. _____ T. _____ N. _____ S., R. _____ E. _____ W., W.M.

Bearing and distance from section or subdivision corner _____

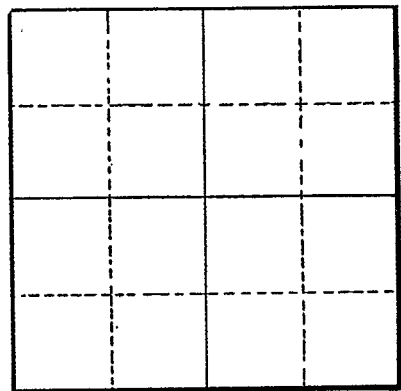

Section _____

Altitude at well _____ 175 _____

TYPE OF WELL: Drilled Date Constructed 1956

Depth drilled _____ 201 _____ Depth cased _____ 201 _____

CASING RECORD:
12 inch

FINISH: Casing perforated 174-176, 180-200

AQUIFERS: Gray sand from 100 to 105
Black sand from 108 to 170
Gravel from 170 to 201

WATER LEVEL: 32.77 feet below land surface on February 1, 1960

PUMPING EQUIPMENT: Type _____ Turbine _____ H.P. _____ 50
Capacity _____ G.P.M.

WELL TESTS:
Drawdown _____ 35 _____ ft. after _____ hours _____ Pumping 300 _____ G.P.M.
Drawdown _____ 85 _____ ft. after _____ hours _____ Pumping 1200 _____ G.P.M.

USE OF WATER Domestic, Irrigation-96 ac. Temp. _____ °F. _____, 19 _____

SOURCE OF INFORMATION USGS

DRILLER or DIGGER _____

ADDITIONAL DATA:
Log _____ X _____ Water Level Measurements _____ Chemical Analysis _____ Aquifer Test _____

REMARKS:

