

STATE ENGINEER
Salem, Oregon

1592
MARI.....

Well Record

STATE WELL NO. 5/1W-6J.....
COUNTY Marion.....
APPLICATION NO. GR-3745.....

OWNER: Edward C. Gorman


MAILING ADDRESS: Route 1, Box 230

LOCATION OF WELL: Owner's No.

CITY AND STATE: Woodburn, Oregon

NE 1/4 SE 1/4 Sec. 6 T. 5 S., R. 1 W., W.M.

Bearing and distance from section or subdivision corner 1050 feet West and 300 feet South from the E/4 Corner, Section 6

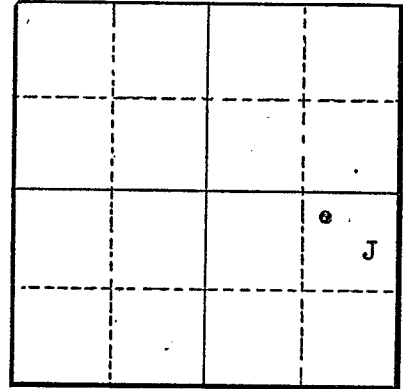

Section 6.....

Altitude at well

TYPE OF WELL: Drilled Date Constructed 1947

Depth drilled 106 feet Depth cased 106 feet

CASING RECORD:

6-inch casing set from 0 to 106 feet (steel casing)

FINISH:

AQUIFERS:

WATER LEVEL:

PUMPING EQUIPMENT: Type Jacuzzi Turbine H.P. Capacity 30 G.P.M.

WELL TESTS:
Drawdown ft. after hours G.P.M.
Drawdown ft. after hours G.P.M.

USE OF WATER Irrigation Temp. °F. 19

SOURCE OF INFORMATION GR-4046

DRILLER or DIGGER

ADDITIONAL DATA:

Log (NA) Water Level Measurements Chemical Analysis Aquifer Test

REMARKS: