

STATE ENGINEER
Salem, Oregon

MARION
16003

Well Record

STATE WELL NO. 10/2W-4F
COUNTY Marion
APPLICATION NO. GR-3816

OWNER: H. T. Snoddy


MAILING ADDRESS: R.F.D. 1, Box 89

LOCATION OF WELL: Owner's No. _____

CITY AND STATE: Turner, Oregon

SE $\frac{1}{4}$ NW $\frac{1}{4}$ Sec. 4 T. 10 S., R. 2 W., W.M.

Bearing and distance from section or subdivision
corner 800' N. & 685' W. of SE property corner

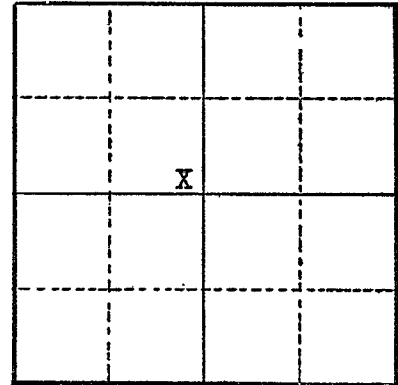

Section 4

Altitude at well _____

TYPE OF WELL: Drilled Date Constructed 1953

Depth drilled 27' 8" Depth cased 27'

CASING RECORD:

10 inch welded steel casing from 0 to 27 feet

FINISH:

AQUIFERS:

WATER LEVEL:

14 feet below surface

PUMPING EQUIPMENT: Type Fairbanks Morse H.P. 15
Capacity 350 G.P.M.

WELL TESTS:

Drawdown _____ ft. after _____ hours _____ G.P.M.

Drawdown _____ ft. after _____ hours _____ G.P.M.

USE OF WATER Irrigation Temp. _____ °F. _____, 19_____

SOURCE OF INFORMATION Well Registration Statement

DRILLER or DIGGER _____

ADDITIONAL DATA:

Log _____ Water Level Measurements _____ Chemical Analysis _____ Aquifer Test _____

REMARKS: