

STATE ENGINEER MARI.....
Salem, Oregon

Well Record

STATE WELL NO. 10/2W-4L(1)
COUNTY Marion
APPLICATION NO. GR-411

16005

OWNER: Autis Hayes


MAILING ADDRESS: Rt. 1 Box 86

LOCATION OF WELL: Owner's No. 1

CITY AND STATE: Turner, Oregon

NE 1/4 SW 1/4 Sec. 4 T. 10 S., R. 2 W., W.M.

Bearing and distance from section or subdivision corner 690' S. & 920' W. from center of sec. 4

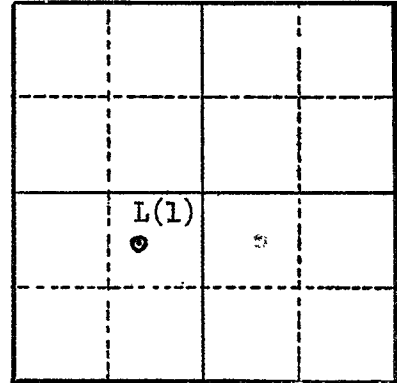

Section 4

Altitude at well 278'

TYPE OF WELL: Drilled Date Constructed Apr. 1939

Depth drilled 29' Depth cased 29'

CASING RECORD:
8 inch

FINISH:

AQUIFERS:

WATER LEVEL:

PUMPING EQUIPMENT: Type F. M. H.P. 25
Capacity G.P.M.

WELL TESTS:
Drawdown ft. after hours G.P.M.
Drawdown ft. after hours G.P.M.

USE OF WATER Irrigation (33.3 acres) Temp. °F. , 19

SOURCE OF INFORMATION GR-394

DRILLER or DIGGER

ADDITIONAL DATA:

Log NA Water Level Measurements Chemical Analysis Aquifer Test

REMARKS: