

STATE ENGINEER  
Salem, Oregon

MAR 16 1939

# Well Record

STATE WELL NO. 10/2W-4M(1)  
COUNTY Marion  
APPLICATION NO. GR-411

OWNER: Antis Hayes


MAILING ADDRESS: Rt. 1 Box 86

LOCATION OF WELL: Owner's No. 2

CITY AND STATE: Turner, Oregon

NW 1/4 SW 1/4 Sec. 4 T. 10 S., R. 4 W., W.M.

Bearing and distance from section or subdivision corner 320' S. & 1800' W. of center of sec. 4

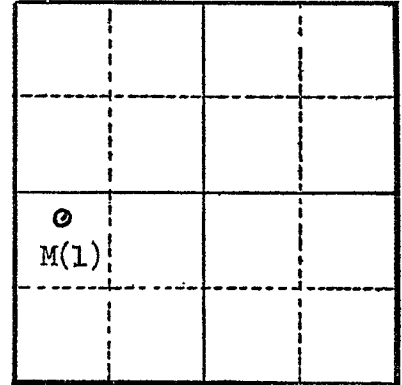

Section 4

Altitude at well 278'

TYPE OF WELL: Drilled Date Constructed Apr. 1939

Depth drilled 29' Depth cased 29'

CASING RECORD:  
8 inch

FINISH:

AQUIFERS:

WATER LEVEL:

PUMPING EQUIPMENT: Type F. M. H.P. 25  
Capacity G.P.M.

WELL TESTS:  
Drawdown ft. after hours G.P.M.  
Drawdown ft. after hours G.P.M.

USE OF WATER Irrigation (18.7 acres) Temp. °F. 19

SOURCE OF INFORMATION GR-394  
DRILLER or DIGGER Marion West, Salem

ADDITIONAL DATA:  
Log NA Water Level Measurements Chemical Analysis Aquifer Test

REMARKS: