

STATE ENGINEER  
Salem, Oregon

MAR 1 1967

# Well Record

STATE WELL NO. 10/2W-4N(1)  
COUNTY Marion  
APPLICATION NO. GR-170

OWNER: Ernest L. & Pearl F. Pletzer


MAILING ADDRESS: Rt. 1 Box 82

LOCATION OF WELL: Owner's No. 1

CITY AND STATE: Turner, Oregon

SW <sup>NX</sup> 1/4 SW <sup>NX</sup> 1/4 Sec. 4 T. 10 S., R. 2 W., W.M.

Bearing and distance from section or subdivision corner 1968.83' N. & 1487.82' W. of SE cor. of the Wm. McKinney DIC.

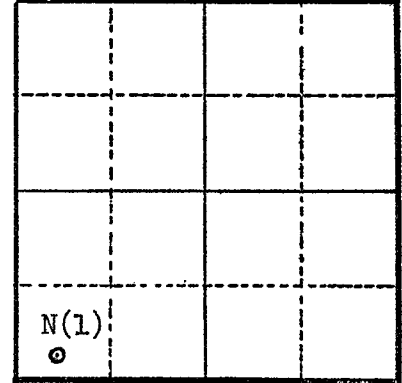

Altitude at well 275'

TYPE OF WELL: Drilled Date Constructed 6/1/41

Depth drilled 30' Depth cased 30'

Section 4

### CASING RECORD:

8 inch set from 0 to 30 feet

### FINISH:

24 slots/ft. (1/2"x2") set from 24 to 30 feet

### AQUIFERS:

Sand & gravel from 0 to 30 feet

### WATER LEVEL:

13 feet below land surface  
11.32 (7-25-57)

PUMPING EQUIPMENT: Type Pacific, centrifugal H.P. 20  
Capacity 500 G.P.M.

### WELL TESTS:

Drawdown 1 ft. after 500 hours G.P.M.  
Drawdown ft. after hours G.P.M.

USE OF WATER Irrigation (29.51 acres) Temp. °F., 19

SOURCE OF INFORMATION GR-161

DRILLER or DIGGER

### ADDITIONAL DATA:

Log  Water Level Measurements  Chemical Analysis  Aquifer Test

### REMARKS:

Sand & gravel 0 to 30

See hydrographs