

STATE ENGINEER
Salem, Oregon

16008
MARI...

Well Record

STATE WELL NO. 10/2W-4N(2)
COUNTY Marion
APPLICATION NO. GR-170

OWNER: Ernest L. & Pearl F. Pletzer


MAILING ADDRESS: Rt. 1 Box 82

LOCATION OF WELL: Owner's No. 4

CITY AND STATE: Turner, Oregon

SW ^{NX} 1/4 SW ^{NX} 1/4 Sec. 4 T. 10 S., R. 2 W., W.M.

Bearing and distance from section or subdivision corner N.21°36'W. 3204.84' from SE cor. of the Wm. McKinney DLC.

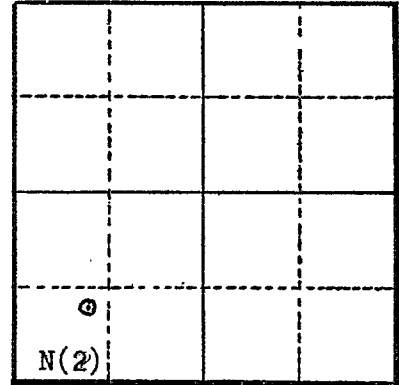

Altitude at well 275'

TYPE OF WELL: Drilled Date Constructed 6/1/39

Depth drilled 30' Depth cased 30'

Section 4

CASING RECORD:

8 inch set from 0 to 30 feet

FINISH:

24 slots/ft. (1/2"x2") set from 24 to 30 feet

AQUIFERS:

Sand & gravel from 0 to 30 feet

WATER LEVEL:

13 feet below land surface

PUMPING EQUIPMENT: Type Pacific, centrifugal H.P. 15
Capacity 350 G.P.M.

WELL TESTS:

Drawdown ft. after hours G.P.M.
Drawdown ft. after hours G.P.M.

USE OF WATER Irrigation (35.42 acres) Temp. °F., 19.....

SOURCE OF INFORMATION GR-161

DRILLER or DIGGER

ADDITIONAL DATA:

Log Water Level Measurements Chemical Analysis Aquifer Test

REMARKS:

Sand & gravel 0 to 30