

STATE ENGINEER
Salem, Oregon

Well Record

STATE WELL NO. 10/2W-5P
COUNTY Marion
APPLICATION NO. GR-888

OWNER: Albert Harnisch

MAILING

ADDRESS: Rt. 2, Box 348

LOCATION OF WELL: Owner's No.

CITY AND

STATE: Albany, Oregon

SE $\frac{1}{4}$ SW $\frac{1}{4}$ Sec. 5 T. 10 S. R. 2 W., W.M.

Bearing and distance from section or subdivision


corner N. 39° 45' W. 15 chs. from SE cor. SW $\frac{1}{4}$ Sec. 5

Altitude at well 285 ft.

TYPE OF WELL: drilled Date Constructed May 1938

Depth drilled 26 ft. Depth cased 26 ft.

CASING RECORD: 8" steel 0 to 26 ft.

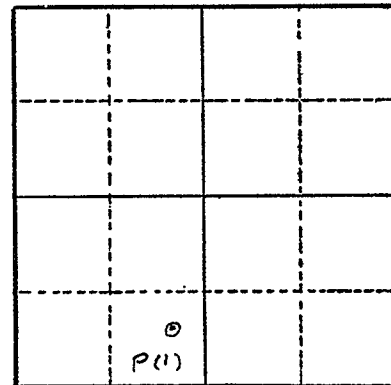

Section 5

FINISH: 8" steel 0 to 26 ft.
Perforated from 14 to 26 ft. Slot perforations

AQUIFERS:

WATER LEVEL: 14 ft.

PUMPING EQUIPMENT: Type Cornell 3" centrifugal H.P. 15 elec.
Capacity 400 G.P.M.

WELL TESTS:
Drawdown 5 ft. after hours 400 G.P.M.
Drawdown ft. after hours G.P.M.

USE OF WATER irrigation Temp. °F. 19

SOURCE OF INFORMATION owner

DRILLER or DIGGER Bill Hamilton Drilling Co.

ADDITIONAL DATA:

Log Water Level Measurements Chemical Analysis Aquifer Test

REMARKS: