

STATE ENGINEER
Salem, Oregon

16029
MAR 1941

Well Record

STATE WELL NO. 10/2W-5J(1)
COUNTY Marion
APPLICATION NO. GR-1054

GR- 1016

OWNER: Leroy & Deroy McGill

MAILING
ADDRESS:


LOCATION OF WELL: Owner's No. #1

CITY AND
STATE: Marion, Oregon

NE 1/4 SE 1/4 Sec. 5 T. 10 S., R. 2 W., W.M.

Bearing and distance from section or subdivision

corner 1770' S. & 1679' E. of NW cor. of the
Wm. McKinney DLC.

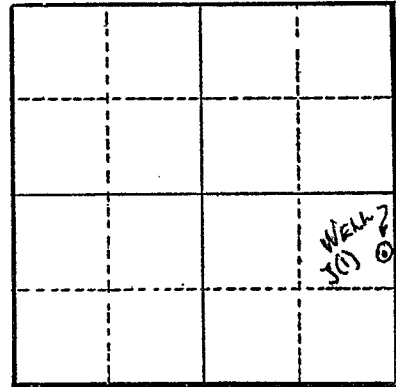

Section 5

Altitude at well

TYPE OF WELL: Drilled Date Constructed 1941

Depth drilled 30 ft. Depth cased 30 ft.

CASING RECORD:

8 inch

FINISH:

Perforated - 1/2" x 6" (3 per ft.) from 15 to 30 ft.

AQUIFERS:

Water bearing gravel at 10 ft.

WATER LEVEL:

10 ft.

PUMPING EQUIPMENT: Type F. M. 4" Cent.

H.P. 25

Capacity 500 G.P.M.

WELL TESTS:

Drawdown 15 ft. after 600 hours G.P.M.

Drawdown ft. after hours G.P.M.

USE OF WATER Irrigation Temp. °F. 19

SOURCE OF INFORMATION G.R. Record

DRILLER or DIGGER West Well Drilling

ADDITIONAL DATA:

Log N.A. Water Level Measurements Chemical Analysis Aquifer Test

REMARKS:

Irrigation of 32.5 acres.