

STATE ENGINEER
Salem, Oregon

MAR. 10 1930

Well Record

STATE WELL NO. 10/2W-5J(2)
COUNTY Marion
APPLICATION NO. GR-1055

GR- 1017

OWNER: Leroy & Deroy McGill


MAILING
ADDRESS:

LOCATION OF WELL: Owner's No. #2

CITY AND
STATE: Marion, Oregon

NE 1/4 SE 1/4 Sec. 5 T. 10 S., R. 2 W., W.M.

Bearing and distance from section or subdivision
corner 1900' S. & 1201' E. of NW cor. of the
Wm. McKimney DLC.

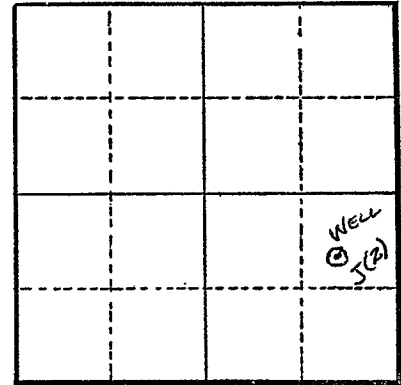

Altitude at well 277 ft.

TYPE OF WELL: Drilled Date Constructed 1946

Depth drilled 40 ft. Depth cased 40 ft.

Section 5

CASING RECORD:

8 inch

FINISH:

Perforated- 1/2" x 6" (3 per ft.) from 25 to 40 ft.

AQUIFERS:

WATER LEVEL:

10 ft.

PUMPING EQUIPMENT: Type Pacific 3" Cent. H.P. 15

Capacity 350 G.P.M.

WELL TESTS:

Drawdown 18 ft. after 400 hours G.P.M.

Drawdown ft. after hours G.P.M.

USE OF WATER Irrigation Temp. °F. 19

SOURCE OF INFORMATION G.R. Record

DRILLER or DIGGER West Well Drilling

ADDITIONAL DATA:

Log N.A. Water Level Measurements Chemical Analysis Aquifer Test

REMARKS:

Irrigation of 52.2 acres.