

STATE ENGINEER  
Salem, Oregon

MARI...  
16035

# Well Record

STATE WELL NO. 10/2W-5P(1)  
COUNTY Marion  
APPLICATION NO. GR-1186

GR- 1147

OWNER: Laura M. Thomas

MAILING ADDRESS: Rt. 1, Box 76


LOCATION OF WELL: Owner's No.

CITY AND STATE: Turner, Oregon

SE 1/4 SW 1/4 Sec. 5 T. 10 S., R. 2 W., W.M.

Bearing and distance from section or subdivision

corner 1325' S. & 100' W. from Center Section 5.

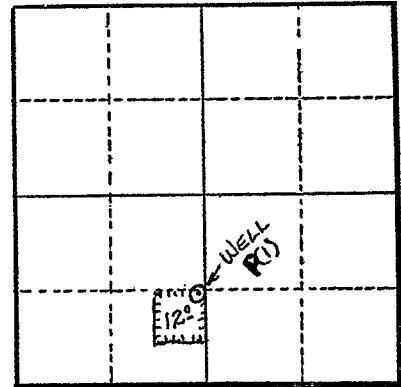

Section 5

Altitude at well

TYPE OF WELL: Drilled Date Constructed 1952

Depth drilled 50 ft. Depth cased

CASING RECORD:

8 in. hole

FINISH:

AQUIFERS:

WATER LEVEL:

8 ft.

PUMPING EQUIPMENT: Type Berkeley 3 in. H.P. 38

Capacity 450 G.P.M.

WELL TESTS:

Drawdown 16 ft. after 200 hours G.P.M.

Drawdown ft. after hours G.P.M.

USE OF WATER Irrigation Temp. °F., 19

SOURCE OF INFORMATION G. R. Record

DRILLER or DIGGER Burkhart

ADDITIONAL DATA:

Log N.A. Water Level Measurements Chemical Analysis Aquifer Test

REMARKS:

Irrigation of 12 acres.