

STATE ENGINEER  
Salem, Oregon

MARION 10053

# Well Record

STATE WELL NO. 10/2W-6J(1)  
COUNTY Marion  
APPLICATION NO. GR- 916

OWNER: John K. Kihs


MAILING ADDRESS: Rt. 1 Box 256

LOCATION OF WELL: Owner's No.

CITY AND STATE: Jefferson, Oregon

NE 1/4 SE 1/4 Sec. 6 T. 10 S., R. 2 W., W.M.

Bearing and distance from section or subdivision corner 130' W. & 157' S. of E 1/4 cor. of sec. 6

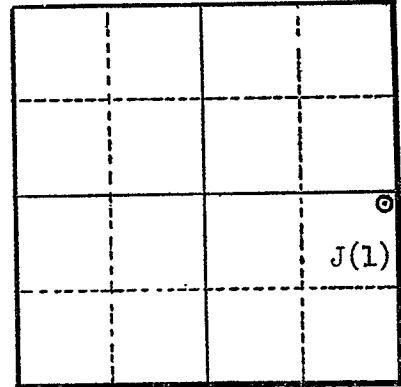

Altitude at well 277'

TYPE OF WELL: Drilled Date Constructed Jan. 1945

Depth drilled 69' Depth cased 64'

Section 6

### CASING RECORD:

6 inch set from 0 to 64 feet

### FINISH:

Open end casing

### AQUIFERS:

Hard gravel from 2 to 55 feet

### WATER LEVEL:

5 feet

PUMPING EQUIPMENT: Type Jacuzzi, jet (1 1/4" x 1 1/4") single phase H.P. 1  
Capacity 25 G.P.M.

### WELL TESTS:

Drawdown 40 ft. after 25 hours G.P.M.  
Drawdown ft. after hours G.P.M.

USE OF WATER Irrigation Temp. °F., 19

SOURCE OF INFORMATION GR- 918  
DRILLER or DIGGER Clifford Studebaker

### ADDITIONAL DATA:

Log  Water Level Measurements  Chemical Analysis  Aquifer Test

### REMARKS:

Dirt 0 to 2  
Hard gravel 2 to 55  
Sandy clay 55 to 69