

STATE ENGINEER
Salem, Oregon

MARION
16079

Well Record


STATE WELL NO. 10/2W - 7N
-COUNTY LINN
APPLICATION NO. GR-2041

OWNER: L. Charles and Alice Henion MAILING ADDRESS: Rt. 2, Box 359

LOCATION OF WELL: Owner's No. _____ CITY AND STATE: Albany, Oregon

SW 1/4 SW 1/4 Sec. 7 T. 10 ^{N.} S., R. 2 ^{E.} W., W.M.

Bearing and distance from section or subdivision corner 225' E. and 450' N.

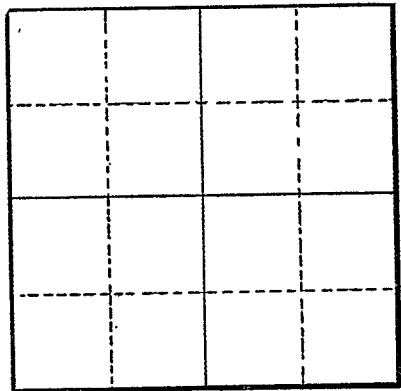

Section _____

Altitude at well _____

TYPE OF WELL: Drilled Date Constructed 1947

Depth drilled 21 Depth cased 21

CASING RECORD:

8-inch

FINISH: Perforations from 15 to 21

AQUIFERS: Sand and gravel

WATER LEVEL: 12-feet

PUMPING EQUIPMENT: Type Fairbanks Morse H.P. 10
Capacity 300 G.P.M.

WELL TESTS:
Drawdown 4 ft. after _____ hours Pumping 250 G.P.M.
Drawdown _____ ft. after _____ hours _____ G.P.M.

USE OF WATER Irrigation Temp. _____ °F., 19_____
SOURCE OF INFORMATION GR-1967

DRILLER or DIGGER _____
ADDITIONAL DATA:
Log _____ Water Level Measurements _____ Chemical Analysis _____ Aquifer Test _____

REMARKS: Sand & Gravel