

STATE ENGINEER
Salem, Oregon

16580
MARI.....

Well Record

STATE WELL NO. 10/2W-7P(2)
COUNTY Marion
APPLICATION NO. GR-3566

OWNER: H. L. Oldenburg


MAILING ADDRESS: Route 1, Box 220

LOCATION OF WELL: Owner's No.

CITY AND STATE: Jefferson, Oregon

SE $\frac{1}{4}$ SW $\frac{1}{4}$ Sec. 7 T. 10 N. S., R. 2 W., W.M.

Bearing and distance from section or subdivision corner

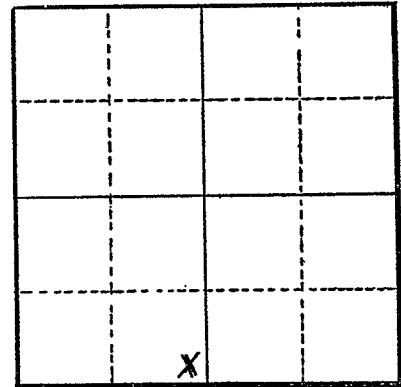

Altitude at well

TYPE OF WELL: Drilled Date Constructed Apr., 1950

Depth drilled 22 ft. Depth cased 22 ft.

Section7.....

CASING RECORD:

6 inch casing set to 22 feet

FINISH:

perforated but size unknown

AQUIFERS:

sediments

WATER LEVEL:

12 feet below surface

PUMPING EQUIPMENT: Type Pacific Centrifugal H.P. 10
Capacity 200 G.P.M.

WELL TESTS:

Drawdown 2 $\frac{1}{2}$ ft. after hours 200 G.P.M.
Drawdown ft. after hours G.P.M.

USE OF WATER Irrigation Temp. °F., 19.....

SOURCE OF INFORMATION Well Registration Statement

DRILLER or DIGGER

ADDITIONAL DATA:

Log X Water Level Measurements Chemical Analysis Aquifer Test

REMARKS:

Log:	Thickness	Depth to Bottom
Soil	4	4
Sand, coarse gravel and boulders	18 ⁺	22