

STATE ENGINEER
Salem, Oregon

MARI...
16083

Well Record

STATE WELL NO. 10/2W-7Q
COUNTY Marion
APPLICATION NO. GR-3435

OWNER: Paul G. Smith


MAILING ADDRESS: RFD Box 221

LOCATION OF WELL: Owner's No. 2

CITY AND STATE: Jefferson, Oregon

SW 1/4 SE 1/4 Sec. 7 T. 10 N. S., R. 2 E. W., W.M.

Bearing and distance from section or subdivision corner 726 feet East and 198 feet North from the S/4 Corner, Section 7

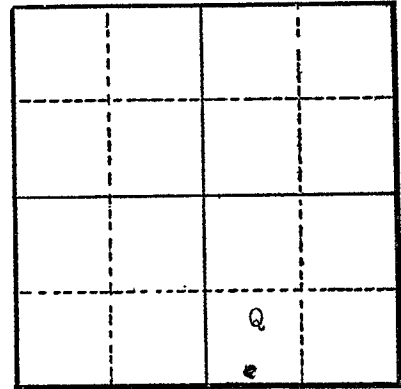

Section 7

Altitude at well

TYPE OF WELL: Driven Date Constructed 1950

Depth drilled 24 feet Depth cased 24 feet

CASING RECORD:

4-inch casing set from 0 to 24 feet

FINISH:

cut with torch from 18 feet to 24 feet

AQUIFERS:

WATER LEVEL:

11 feet

PUMPING EQUIPMENT: Type Fairbanks Morse Centrifugal H.P. 10
Capacity 158 G.P.M.

WELL TESTS:

Drawdown _____ ft. after _____ hours 158 G.P.M.
Drawdown _____ ft. after _____ hours _____ G.P.M.

USE OF WATER Irrigation Temp. _____ °F. _____, 19

SOURCE OF INFORMATION GR-4035

DRILLER or DIGGER

ADDITIONAL DATA:

Log (NA) Water Level Measurements _____ Chemical Analysis _____ Aquifer Test _____

REMARKS: