

STATE ENGINEER
Salem, Oregon

16084
MARI.....

Well Record

STATE WELL NO. 10/2W-7Q
COUNTY Marion
APPLICATION NO. GR-3434

OWNER: Paul G. Smith


MAILING ADDRESS: RFD. Box 221

LOCATION OF WELL: Owner's No. 1

CITY AND STATE: Jefferson, Oregon

.SW 1/4 SE 1/4 Sec. 7 T. 10 S., R. 2 W., W.M.

Bearing and distance from section or subdivision corner 660 feet North and 66 feet East from the S 1/4 Corner, Section 7.

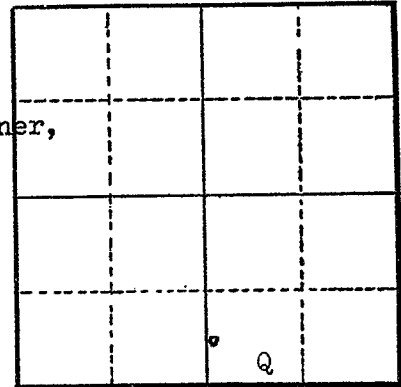

Section 7

Altitude at well

TYPE OF WELL: Dug Date Constructed 1937

Depth drilled 6 feet Depth cased

CASING RECORD:

FINISH:

AQUIFERS:

gravel

WATER LEVEL:

surface of ground

PUMPING EQUIPMENT: Type Bingham 2 1/2 x 3 centrifugal H.P. 10
Capacity 225 G.P.M.

WELL TESTS:

Drawdown 8" after hours 190 G.P.M.
Drawdown ft. after hours G.P.M.

USE OF WATER Irrigation Temp. °F., 19

SOURCE OF INFORMATION GR-4034

DRILLER or DIGGER

ADDITIONAL DATA:

Log x Water Level Measurements Chemical Analysis Aquifer Test

REMARKS:

.Gravel 0 to 6