

STATE ENGINEER  
Salem, Oregon

MARI...  
16088

# Well Record

STATE WELL NO. 10/2W-9D(1)  
COUNTY Marion  
APPLICATION NO. GR- 170

OWNER: Ernest L. & Pearl F. Pletzer


MAILING ADDRESS: Rt. 1 Box 82

LOCATION OF WELL: Owner's No. 2

CITY AND STATE: Turner, Oregon

NW 1/4 NW 1/4 Sec. 9 T. 10 S., R. 2 W., W.M.

Bearing and distance from section or subdivision corner 2016.43' W. & 1087' N. of the SE cor. of the Wm. McKinney DLC.

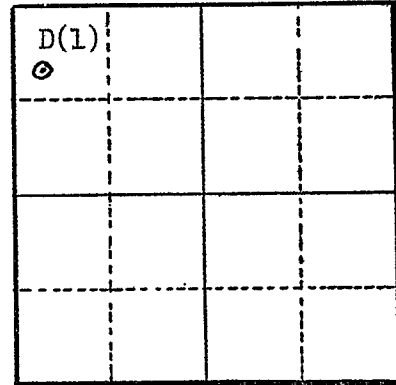

Altitude at well 275'

TYPE OF WELL: Drilled Date Constructed 5/1/46

Depth drilled 30' Depth cased 30'

Section 9

### CASING RECORD:

8 inch set from 0 to 30 feet

### FINISH:

24 rows/ft. (1/2"x2") set from 24 to 30 feet

### AQUIFERS:

Sand & gravel from 0 to 30 feet

### WATER LEVEL:

13 feet below land surface (15 July 1946)

PUMPING EQUIPMENT: Type Pacific, centrifugal 8" H.P. 20  
Capacity 500 G.P.M.

### WELL TESTS:

Drawdown 1 ft. after 500 hours G.P.M.  
Drawdown ft. after hours G.P.M.

USE OF WATER Irrigation (77.57 acres) Temp. °F., 19

SOURCE OF INFORMATION GR- 161

DRILLER or DIGGER

### ADDITIONAL DATA:

Log X Water Level Measurements Chemical Analysis Aquifer Test

### REMARKS:

Sand & gravel 0 to 30