

STATE ENGINEER  
Salem, Oregon

MARI...  
10099

# Well Record

STATE WELL NO. 10/2W-18C(1)  
COUNTY Marion  
APPLICATION NO. GR-1615

GR- 1573

OWNER: Mervin N. McGill


MAILING ADDRESS: Rt. 1

LOCATION OF WELL: Owner's No.

CITY AND STATE: Jefferson, Oregon

NE 1/4 NW 1/4 Sec. 18 T. 10 S., R. 2 W., W.M.

Bearing and distance from section or subdivision corner 1370' E. & 825' S. from NW cor. Sec. 18

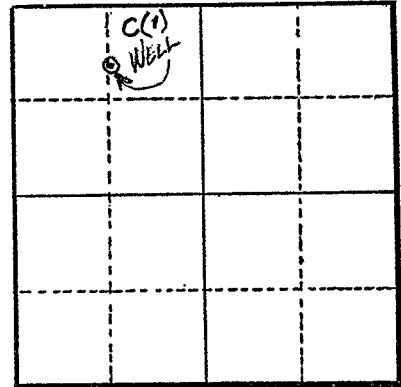

Section 18

Altitude at well 250'

TYPE OF WELL: Driven Date Constructed 1945

Depth drilled 25' Depth cased 25'

### CASING RECORD:

4"

### FINISH:

Perforated with torch slots from 18 to 25 ft.

### AQUIFERS:

### WATER LEVEL:

6 - 10 ft. (Spring to Summer)

PUMPING EQUIPMENT: Type F. M. 3" Cent. H.P. 15  
Capacity 400 G.P.M.

### WELL TESTS:

Drawdown ft. after hours G.P.M.  
Drawdown ft. after hours G.P.M.

USE OF WATER Irrigation Temp. °F., 19

SOURCE OF INFORMATION GR Record

DRILLER or DIGGER Owner

ADDITIONAL DATA:  
Log Water Level Measurements Chemical Analysis Aquifer Test

### REMARKS:

Log: Top soil 0 to 4 ft.  
Gravel & sand 4 to 25 ft.

Irrigation of 24.33 acres.