

STATE ENGINEER  
Salem, Oregon

# Well Record

STATE WELL NO. 10 / 2W - 18C  
COUNTY MARION  
APPLICATION NO. GR-1969

MARI...  
16100

OWNER: Roy D. Tilley


MAILING ADDRESS: Route 1

LOCATION OF WELL: Owner's No. \_\_\_\_\_

CITY AND STATE: Jefferson, Oregon

NE 1/4 NW 1/4 Sec. 18 T. 10 N. S., R. 2 E. W., W.M.

Bearing and distance from section or subdivision corner 350' W. & 450' S.

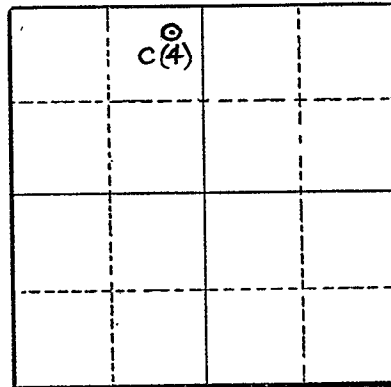

Section \_\_\_\_\_

Altitude at well \_\_\_\_\_

TYPE OF WELL: Drove Date Constructed 1945

Depth drilled 21 Depth cased 21

### CASING RECORD:

4-inch

### FINISH:

Perforation from 10 to 21

### AQUIFERS:

Sand & Gravel

### WATER LEVEL:

10-feet

PUMPING EQUIPMENT: Type Wiess Centrifugal H.P. 5  
Capacity 125 G.P.M.

### WELL TESTS:

Drawdown \_\_\_\_\_ ft. after \_\_\_\_\_ hours \_\_\_\_\_ G.P.M.  
Drawdown \_\_\_\_\_ ft. after \_\_\_\_\_ hours \_\_\_\_\_ G.P.M.

USE OF WATER Irrigation Temp. \_\_\_\_\_ °F. \_\_\_\_\_, 19\_\_\_\_

SOURCE OF INFORMATION GR-1897

DRILLER or DIGGER \_\_\_\_\_

### ADDITIONAL DATA:

Log \_\_\_\_\_ Water Level Measurements \_\_\_\_\_ Chemical Analysis \_\_\_\_\_ Aquifer Test \_\_\_\_\_

### REMARKS:

Sand & Gravel