

STATE ENGINEER
Salem, Oregon

MARI.....
16102

Well Record

STATE WELL NO. 10/2W-18D(1)
COUNTY Marion
APPLICATION NO. GR- 412

OWNER: O. D. Stephenson

MAILING
ADDRESS:


LOCATION OF WELL: Owner's No.

CITY AND
STATE:

Jefferson, Oregon

NW ¼ NW ¼ Sec. 18 T. 10 S, R. 2 W., W.M.

Bearing and distance from section or subdivision
corner 490' W. & 40' N. from SE cor. of the
Woodfin DLC #64

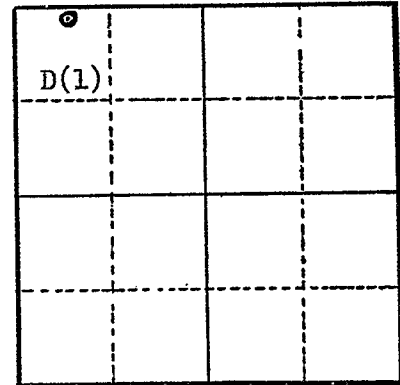

Section 18

Altitude at well 245'

TYPE OF WELL: Drilled Date Constructed Spring '40

Depth drilled 20' Depth cased 20'

CASING RECORD:

8 inch set from 0 to 20 feet

FINISH:

AQUIFERS:

WATER LEVEL:

20 feet below land surface ? 11.61' (6-17-58)

PUMPING EQUIPMENT: Type ~~XXXXXXXXXXXX~~ Centrifugal H.P. 10
Capacity 300 G.P.M.

WELL TESTS:

Drawdown ft. after hours G.P.M.
Drawdown ft. after hours G.P.M.

USE OF WATER Irrigation (14.3 acres) Temp. °F., 19

SOURCE OF INFORMATION GR- 395

DRILLER or DIGGER Marion West

ADDITIONAL DATA:

Log NA Water Level Measurements Chemical Analysis Aquifer Test

REMARKS: